




C.S. 176701 - BRG01861 - NW REGION - TUKWILA TO LUCILLE - STAGE 3 - BR. 5/522W RAIL AND EXP. JT. RETROFIT

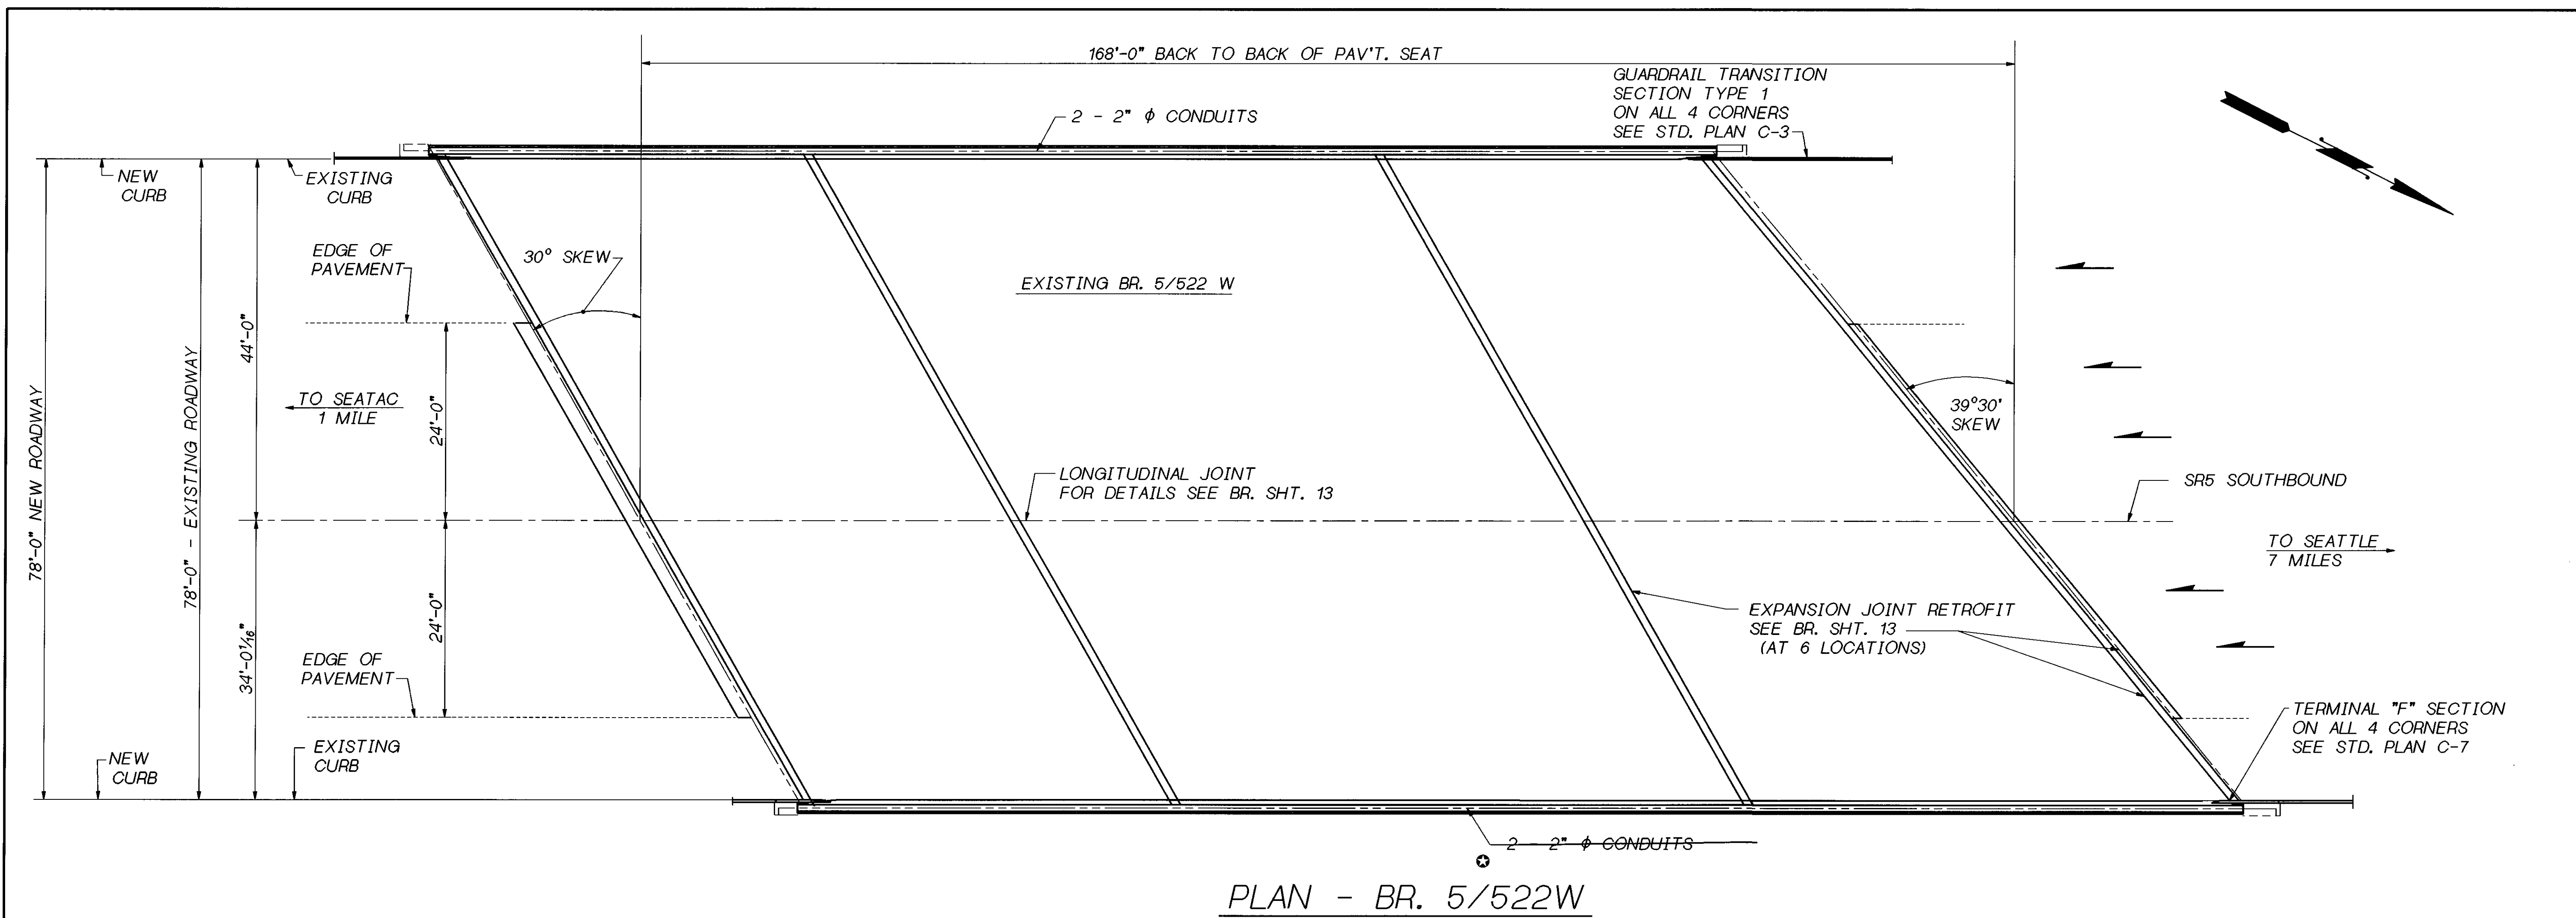


PLAN - BR. 5/522W

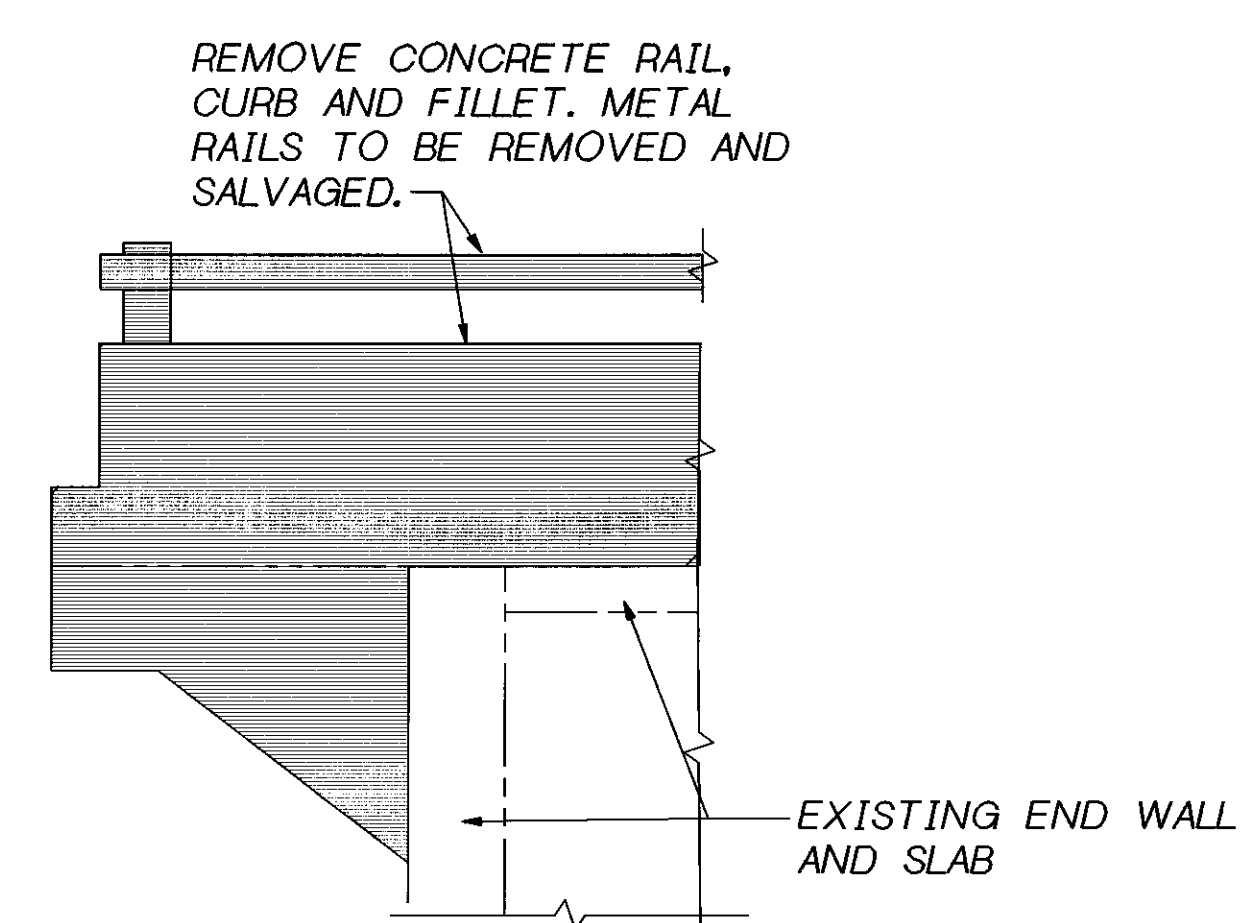


END POST

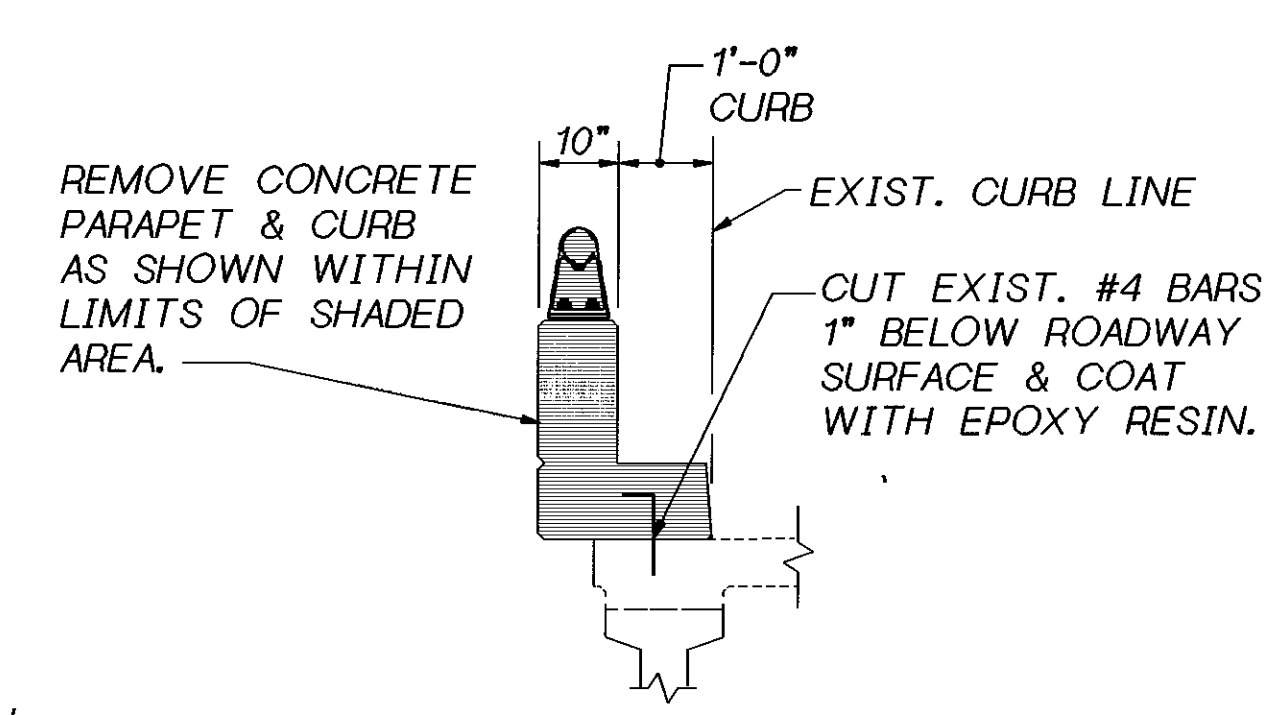

TYPICAL SECTION

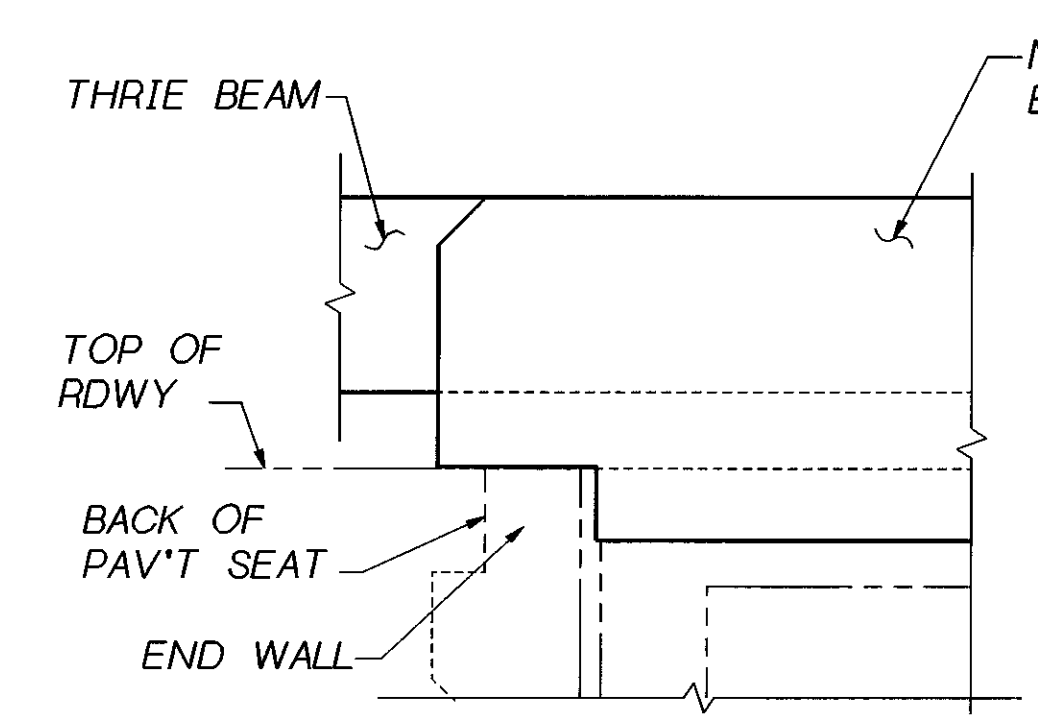

END POST

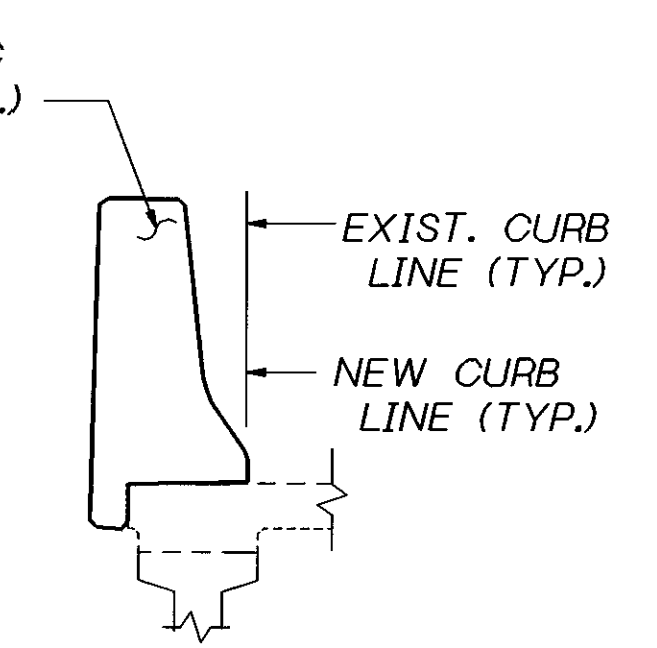

TYPICAL SECTION

NEW TRAFFIC BARRIER

TRAFFIC BARRIER REPLACEMENT

AS BUILT CHANGES 8/99

SR 5 JOB NO. 7025 SHEET 10

Bridge Design Engr. C. C. RUTH					REGION NO.	STATE	FED. AID PROJ. NO.	SHEET NO.	TOTAL SHEETS			BRIDGE AND STRUCTURES OFFICE 2-8-95 BRIDGE DESIGN ENGINEER		SR 5 TUKWILA TO LUCILLE ST. HOV AND SC8DI - STAGE 3 BR. 5/522W LAYOUT	BRIDGE SHEET NO. 10 SHEET 499 OF 642 SHEETS
Supervisor Y. A. MHATRE					10	WASH.									
Designed By G.D. BATTIN 9/94															
Checked By Y.A. MHATRE 9/94															
Detailed By G.D. BATTIN 9/94															
Bridge Projects Engr.					JOB NUMBER										
Prelim. Plan By					94W098										
Architect/Specialist	DATE	REVISION	BY	APP'D	4621										

08-FEB-95

TUK_RTR0007-1.FGB1.D.F5_522W.FGB:1
SR5/2683